


PLAN
SCALE 1" = 20'

LEGEND

- STREET LINES AND DIMENSIONS PREVIOUSLY LAID OUT AND HEREBY RETAINED ARE SHOWN BY FULL BLACK LINES AND BLACK FIGURES.
- STREET LINES AND DIMENSIONS HEREBY ESTABLISHED ARE SHOWN BY FULL RED LINES AND RED FIGURES.
- GRADES HEREBY ESTABLISHED ARE SHOWN BY VERTICAL RED FIGURES.
- GRADES SHOWN ON THIS MAP ARE REFERRED TO THE BOROUGH WORKS DATUM OF THE BOROUGH OF MANHATTAN WHICH IS 2.75 FEET ABOVE MEAN SEA LEVEL AT SANDY HOOK.
- ROADWAY AND SIDEWALK TREATMENT SHOWN IN THIN RED LINES
- STREET LINES HEREBY DISCONTINUED SHOWN IN DASHED RED LINES
- GRADES PREVIOUSLY ESTABLISHED AND HEREBY RETAINED ARE SHOWN BY VERTICAL BLACK FIGURES.
- EXISTING SURFACE GRADES ARE SHOWN BY VERTICAL BLACK FIGURES ENCLOSED IN PARENTHESES.

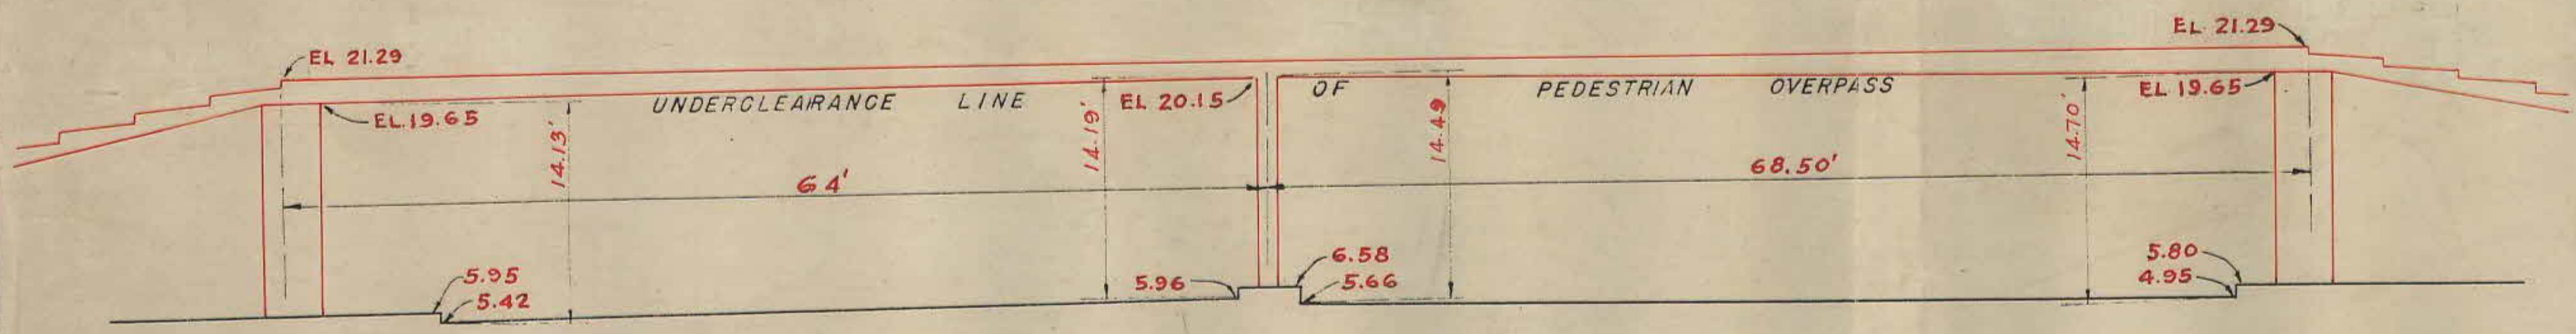

SECTION ACROSS DRIVE
SCALE 1" = 10'

I, ANNA H. CLARK, SECRETARY OF THE BOARD OF ESTIMATE OF THE CITY OF NEW YORK DO HEREBY CERTIFY THAT THIS MAP IS ONE OF FOUR SIMILAR MAPS ADOPTED BY THE SAID BOARD OF ESTIMATE ON THE 5TH DAY OF June 1941.

Anna H. Clark
SECRETARY, BOARD OF ESTIMATE

CITY OF NEW YORK
OFFICE OF THE PRESIDENT BOROUGH OF MANHATTAN
DEPARTMENT OF BOROUGH WORKS
MAP SHOWING A CHANGE IN THE NORTHERLY LINE OF
EAST 25TH STREET AT EAST RIVER DRIVE
AND A CHANGE IN THE EASTERLY LINE OF
EAST RIVER DRIVE AT EAST 25TH STREET
AND LAYING OUT GRADES FOR A
PEDESTRIAN OVERPASS
OVER
EAST RIVER DRIVE
AT EAST 25TH STREET

Wm. H. Keegan
PRESIDENT, BOROUGH OF MANHATTAN
M. O. Brinn
COMMISSIONER OF BOROUGH WORKS

Wm. H. Keegan
CHIEF ENGINEER
John McKeegan
COMMISSIONER OF DOCKS

MARCH 17, 1941

DRAWN BY: E.I.K.
CHECKED BY: G.L.
William Duffett
ACTING SECTION ENGINEER
W. C. Kelly
ENGINEER OF DESIGN

See C.P. 1384
C.P. 1367

12