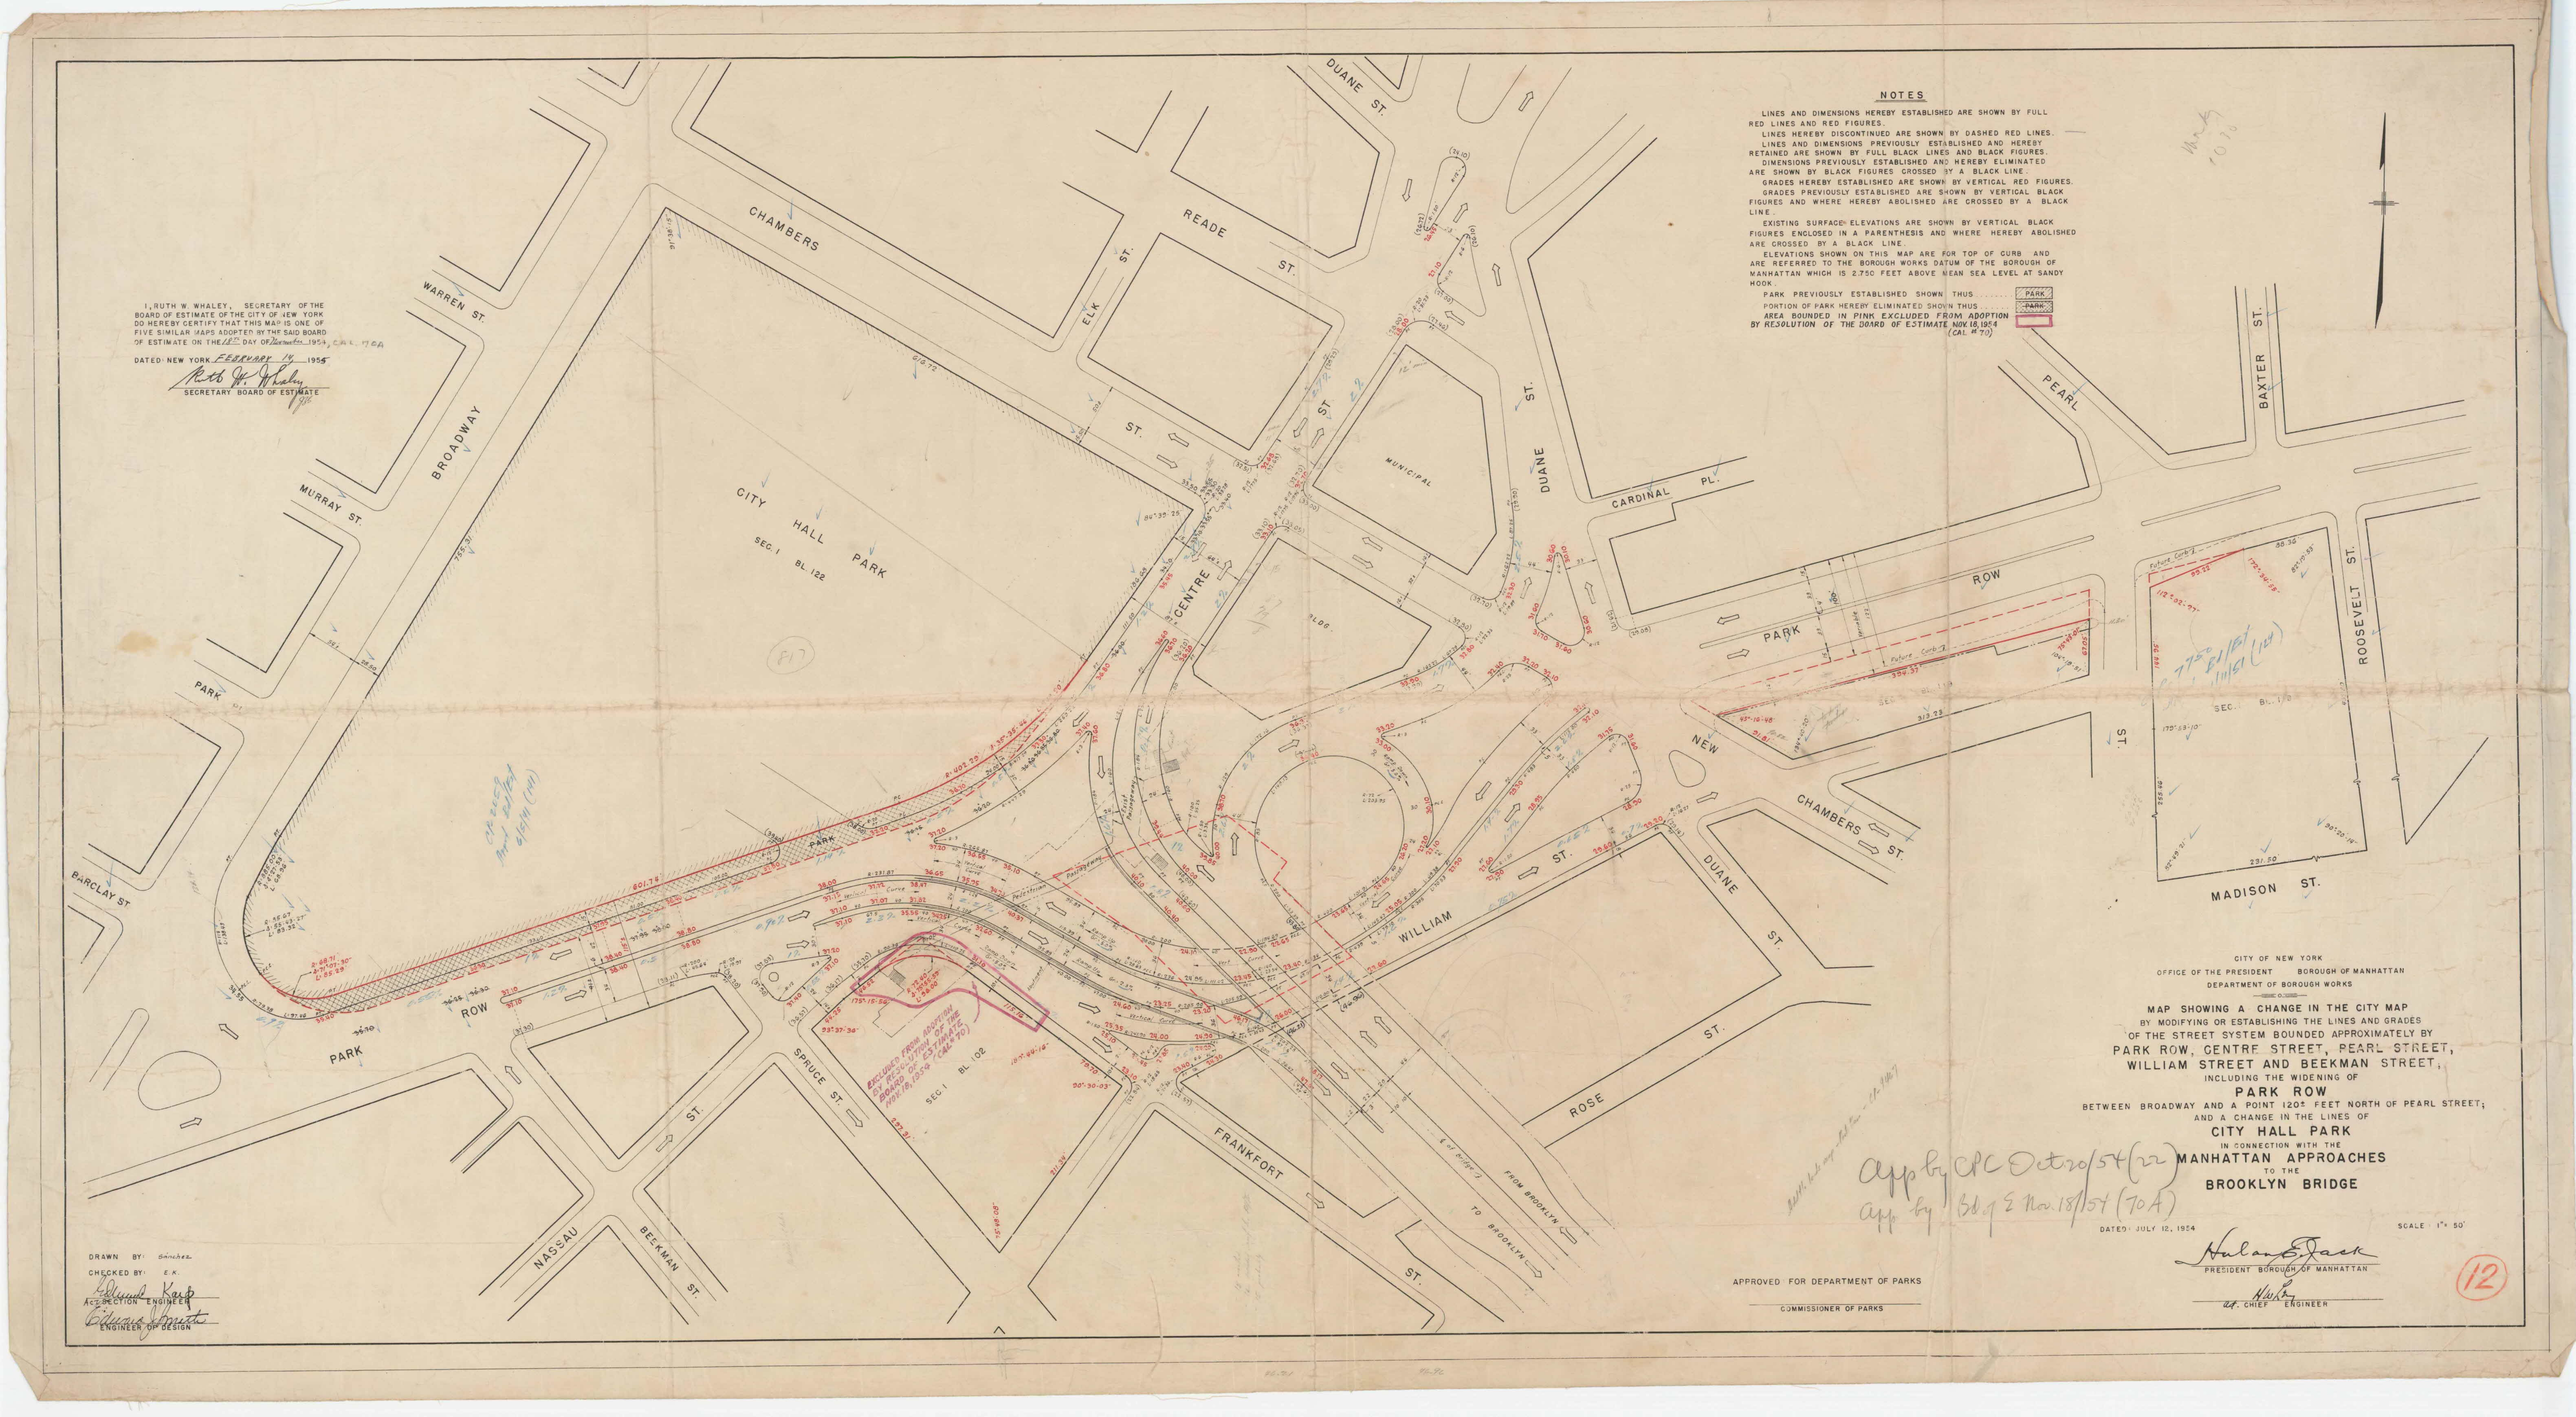

I, RUTH W. WHALEY, SECRETARY OF THE BOARD OF ESTIMATE OF THE CITY OF NEW YORK DO HEREBY CERTIFY THAT THIS MAP IS ONE OF FIVE SIMILAR MAPS ADOPTED BY THE SAID BOARD OF ESTIMATE ON THE 18th DAY OF November 1954, CAL. 70A

DATED: NEW YORK FEBRUARY 14 1955

Ruth W. Whaley
SECRETARY BOARD OF ESTIMATE

NOTES

LINES AND DIMENSIONS HEREBY ESTABLISHED ARE SHOWN BY FULL RED LINES AND RED FIGURES.

LINES HEREBY DISCONTINUED ARE SHOWN BY DASHED RED LINES.

LINES AND DIMENSIONS PREVIOUSLY ESTABLISHED AND HEREBY RETAINED ARE SHOWN BY FULL BLACK LINES AND BLACK FIGURES.

DIMENSIONS PREVIOUSLY ESTABLISHED AND HEREBY ELIMINATED ARE SHOWN BY BLACK FIGURES CROSSED BY A BLACK LINE.

GRADES HEREBY ESTABLISHED ARE SHOWN BY VERTICAL RED FIGURES.

GRADES PREVIOUSLY ESTABLISHED ARE SHOWN BY VERTICAL BLACK FIGURES AND WHERE HEREBY ABOLISHED ARE CROSSED BY A BLACK LINE.

EXISTING SURFACE ELEVATIONS ARE SHOWN BY VERTICAL BLACK FIGURES ENCLOSED IN A PARENTHESIS AND WHERE HEREBY ABOLISHED ARE CROSSED BY A BLACK LINE.

ELEVATIONS SHOWN ON THIS MAP ARE FOR TOP OF CURB AND ARE REFERRED TO THE BOROUGH WORKS DATUM OF THE BOROUGH OF MANHATTAN WHICH IS 2.750 FEET ABOVE MEAN SEA LEVEL AT SANDY HOOK.

PARK PREVIOUSLY ESTABLISHED SHOWN THUS ..... PARK

PORTION OF PARK HEREBY ELIMINATED SHOWN THUS ..... PARK

AREA BOUNDED IN PINK EXCLUDED FROM ADOPTION BY RESOLUTION OF THE BOARD OF ESTIMATE NOV 18, 1954 (CAL. # 70)

CITY OF NEW YORK
OFFICE OF THE PRESIDENT BOROUGH OF MANHATTAN
DEPARTMENT OF BOROUGH WORKS

MAP SHOWING A CHANGE IN THE CITY MAP

BY MODIFYING OR ESTABLISHING THE LINES AND GRADES OF THE STREET SYSTEM BOUNDED APPROXIMATELY BY PARK ROW, CENTRE STREET, PEARL STREET, WILLIAM STREET AND BEEKMAN STREET, INCLUDING THE WIDENING OF PARK ROW BETWEEN BROADWAY AND A POINT 1205 FEET NORTH OF PEARL STREET; AND A CHANGE IN THE LINES OF CITY HALL PARK IN CONNECTION WITH THE MANHATTAN APPROACHES TO THE BROOKLYN BRIDGE

DATED: JULY 12, 1954 SCALE: 1" = 50'

Hulan E. Jack
PRESIDENT BOROUGH OF MANHATTAN

Hulan E. Jack
CHIEF ENGINEER

DRAWN BY: Sanchez.
CHECKED BY: E.K.

Edmund Karb
ACT. SECTION ENGINEER

Edmund Smith
ENGINEER OF DESIGN

APPROVED FOR DEPARTMENT OF PARKS

COMMISSIONER OF PARKS

App'd by CPC Oct 20/54 (22)
App'd by Bd of E Nov. 18/54 (70A)

(12)